


1 LIQUID LINE DETAIL - FUEL TRANSFER STATION
PID103 SCALE: NONE

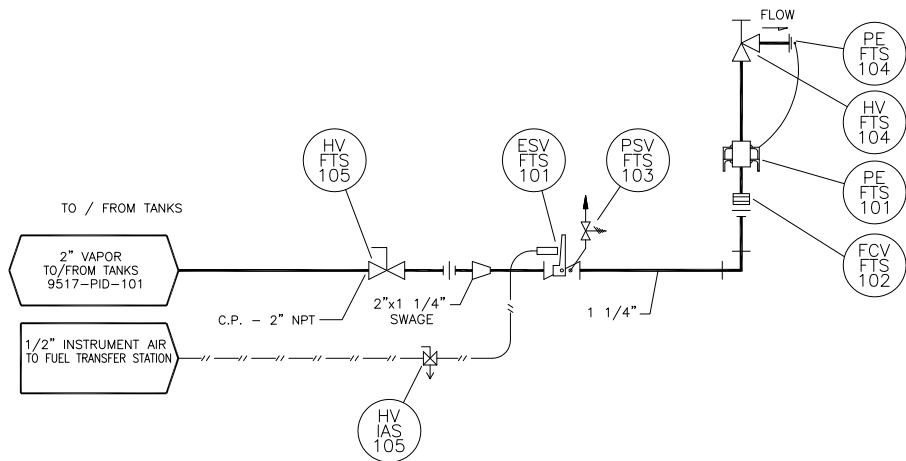

2 VAPOR LINE DETAIL - FUEL TRANSFER STATION
PID103 SCALE: NONE

NOTICE:
THIS DRAWING IS SUPPLIED BY STANDBY SYSTEMS, INC. (SSI) ON A CONFIDENTIAL BASIS TO THE PARTY OR PARTIES NAMED HEREIN SOLELY TO CLARIFY WORK PROPOSED OR CONTRACTED BY SSI. RELEASE TO ANOTHER PARTY OR ANY OTHER USE OF INFORMATION CONTAINED OR REFERENCED HEREIN IS NOT AUTHORIZED BY SSI. THIS DRAWING CONTAINS PROPRIETARY INFORMATION WHICH IS PROTECTED BY COPYRIGHT. ALL RIGHTS ARE RESERVED. REPRODUCTION BY ANY MEANS IS PROHIBITED.
© STANDBY SYSTEMS, INC. 2012



5	AS BUILT	1-3-13
4	FOR CONSTRUCTION	8-3-12
3	REMOVED FLANGE & HYDROSTAT	7-20-12
2	REMOVED BREAK AWAY SWITCH	6-14-12
1	MOVED VAPOR HYDROSTATIC RELIEF VALVE	5-9-12
0	PRELIMINARY	4-26-12
No.	Revision/Issue	Date



Title FLOW DIAGRAM, FUEL TRANSFER STATION	
Drawn By TEL	Date 4-17-12
Approved By —	Date —

Project No. 9517	Drawing No. 9517-PID-103
Date Plotted 1-3-13	Sheet 1 of 1
Scale NONE	